


R:\20209\MA\OUT\02-03-2021\20209_SV01.dwg, 2/3/2021 2:33 PM, Ron Ford, 8Prop-1 Plt, MCLC PDF.p63
Copyright © 2021 Midwestern Consulting L.L.C. All rights reserved. No part of this drawing may be used or reproduced in any form or by any means, or stored in a database or retrieval system, without prior permission of Midwestern Consulting L.L.C.

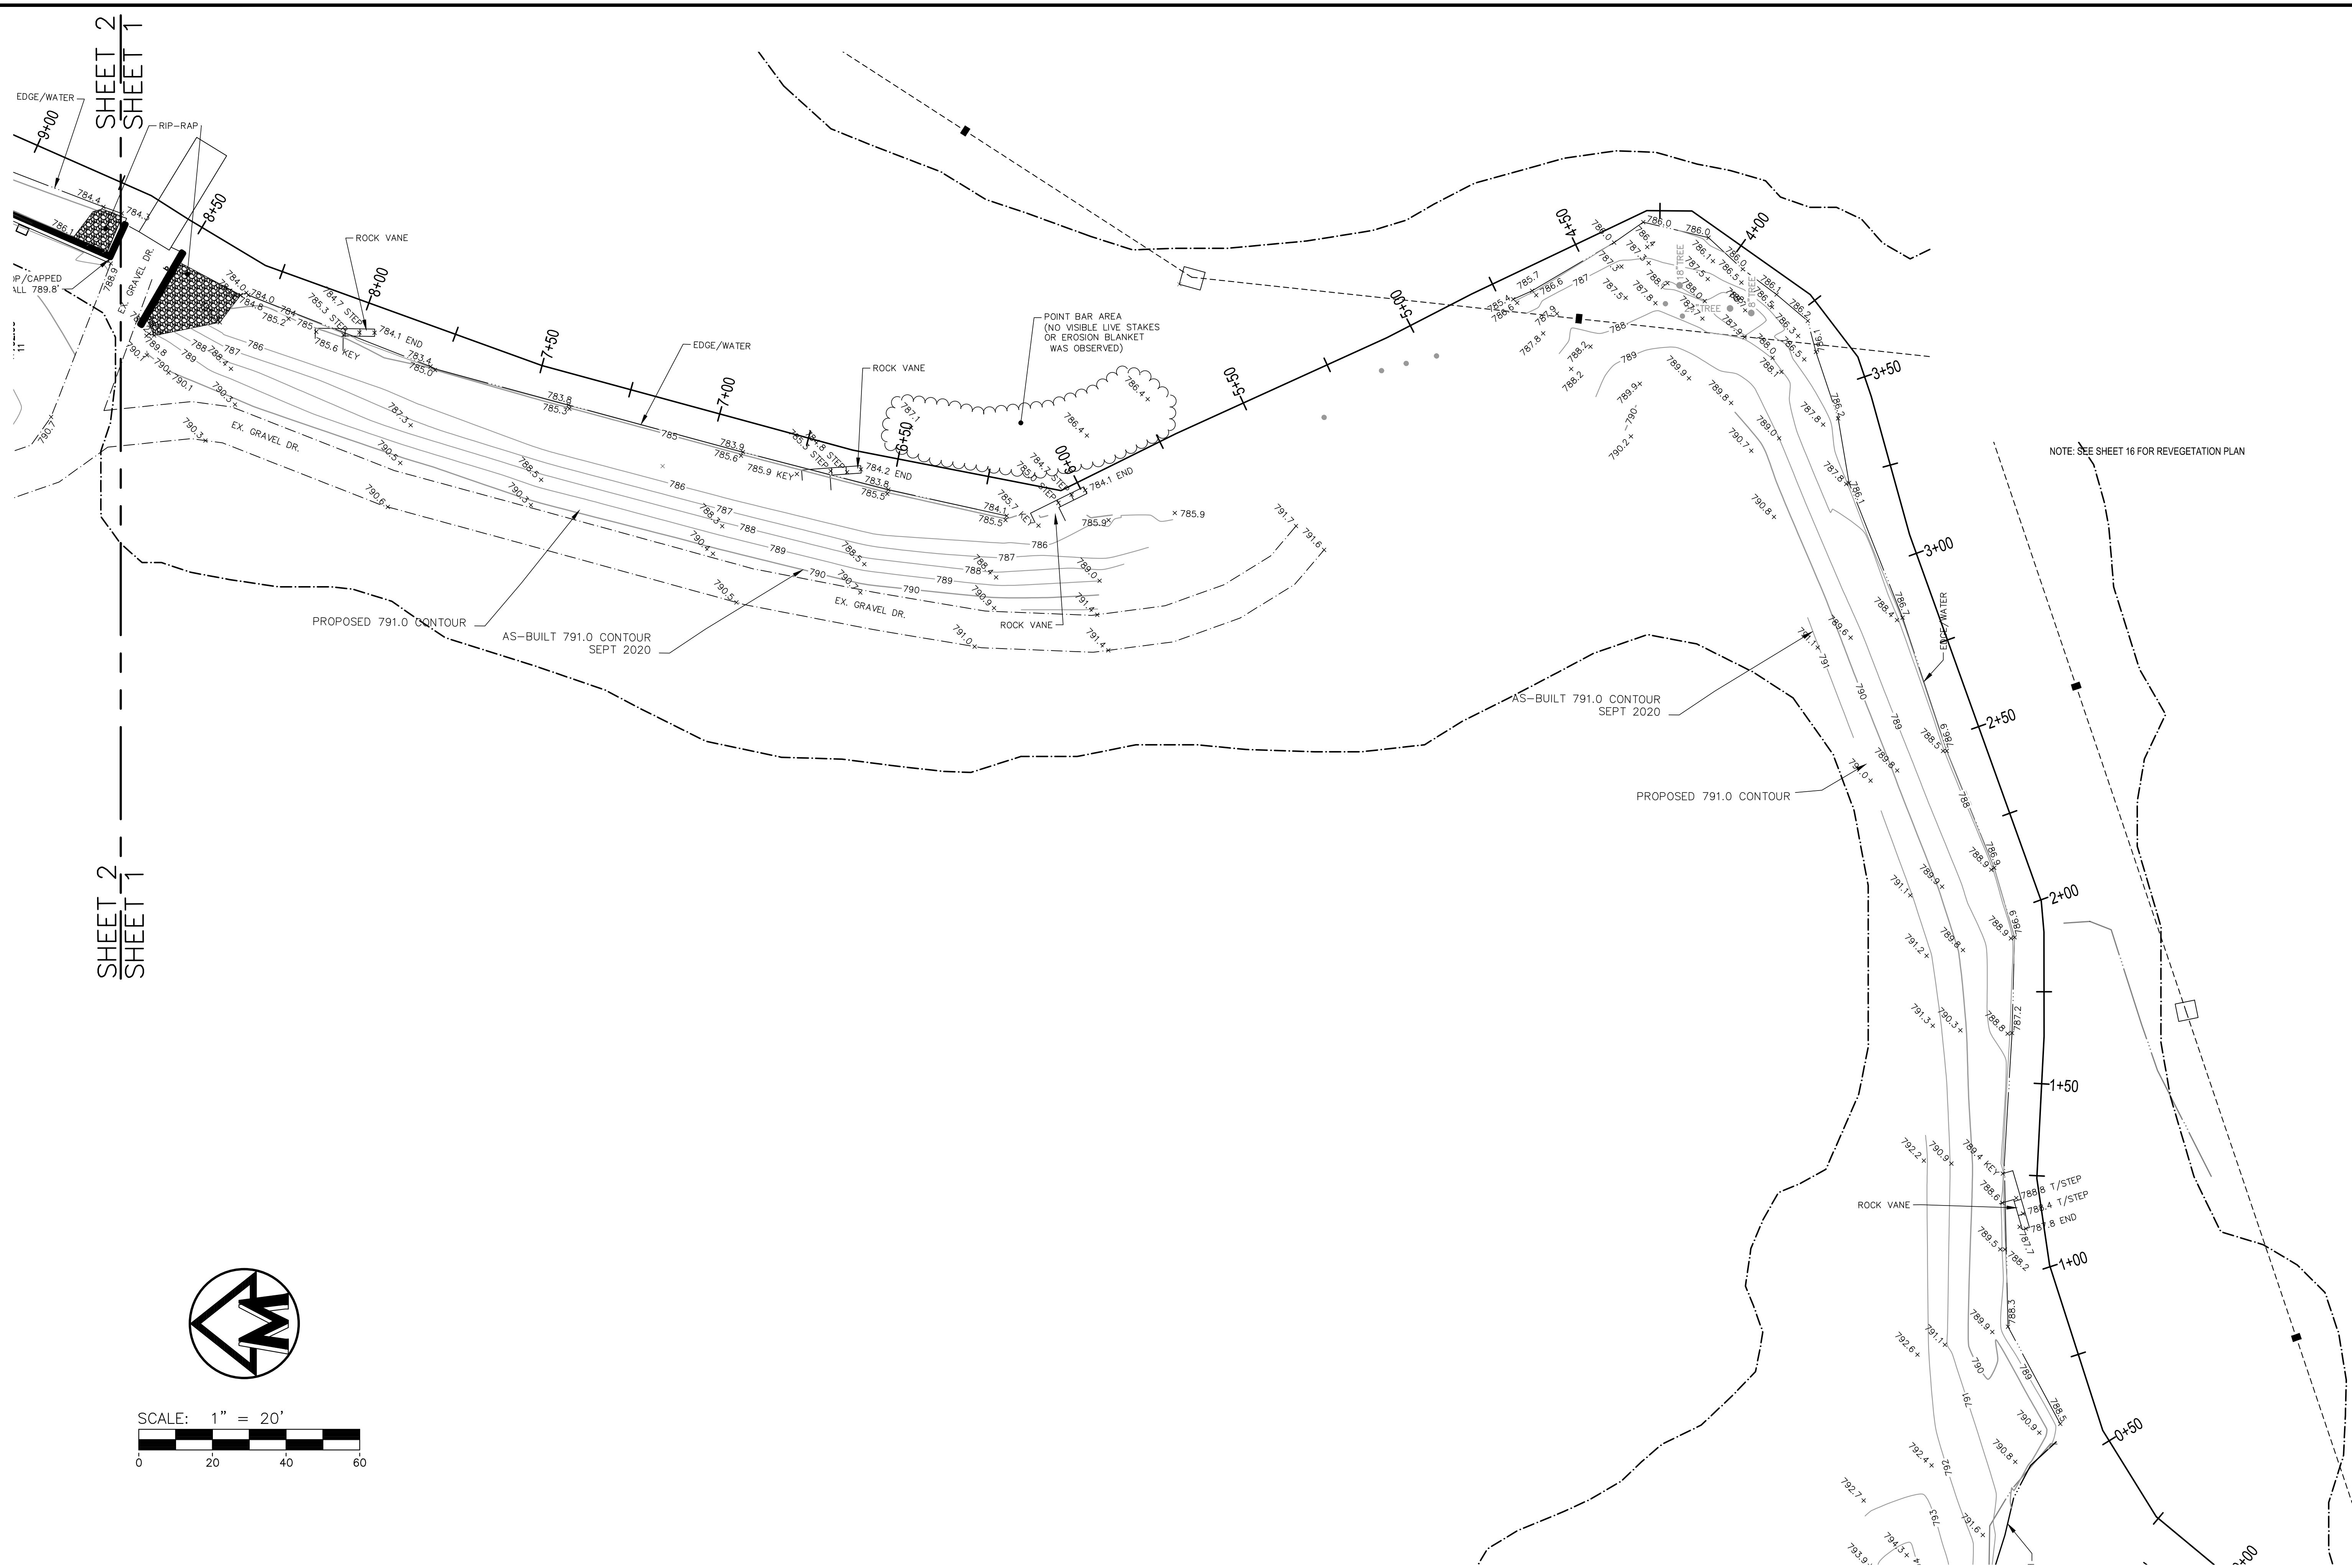

The underground utilities shown have been located from field survey information and existing records. The surveyor makes no guarantees that the underground utilities shown comprise all such utilities in the area, either in-service or abandoned. The surveyor further does not warrant that the underground utilities shown are in the exact location indicated. Although the surveyor does certify that they are located as accurately as possible from the information available.

JOHNSON CREEK

FISH HATCHERY

FINAL AS-BUILTS


1

JOB No. 20209

REVISIONS:	REV. DATE	SHEET 1 OF 2
Added Point Bar Area/Rock Vane	12-31-20	CADD: rg/pk
Added access drive	2-3-21	ENG: [signature]
		TECH: [signature]
		20209_SV01
		FB#

CLIENT

Anglin Civil
1300 Newburg Rd
Livonia, MI 48150


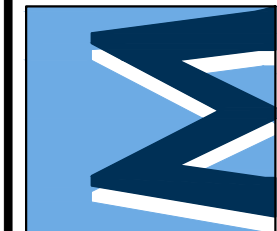


MIDWESTERN
CONSULTING

385 Plaza Drive Ann Arbor, Michigan 48108
734.995.0200 • www.midwesternconsulting.com
Land Development • Surveying • Engineering • Construction Management • Wireless Communications • Transportation • Landfill Services

R:\20209\MA\OUT\02-03-2021\20209_SV01.dwg, 2/3/2021 2:33 PM, Ren For.d, 6Prop-3 P021, MCLLC PDF.p02
Copyright © 2021 Midwestern Consulting L.L.C. All rights reserved. No part of this drawing may be used or reproduced in any form or by any means, or stored in a database or retrieval system, without prior permission of Midwestern Consulting L.L.C.


The underground utilities shown have been located from field survey information and existing records. The surveyor makes no guarantees that the underground utilities shown comprise all such utilities in the area, either in-service or abandoned. The surveyor further does not warrant that the underground utilities shown are in the exact location indicated. Although the surveyor does certify that they are located as accurately as possible from the information available.

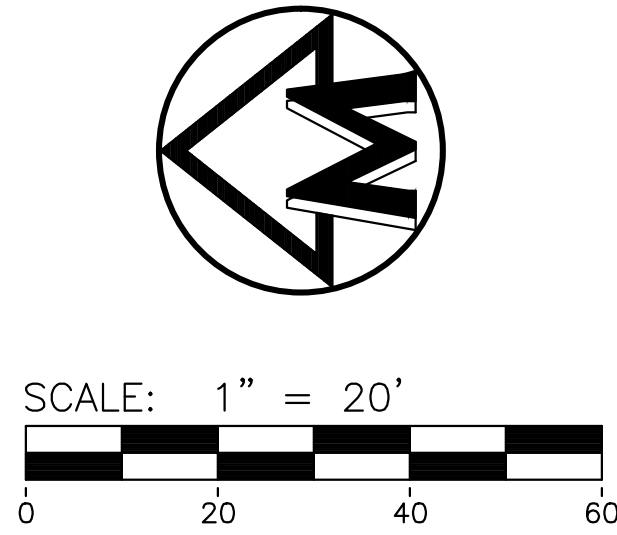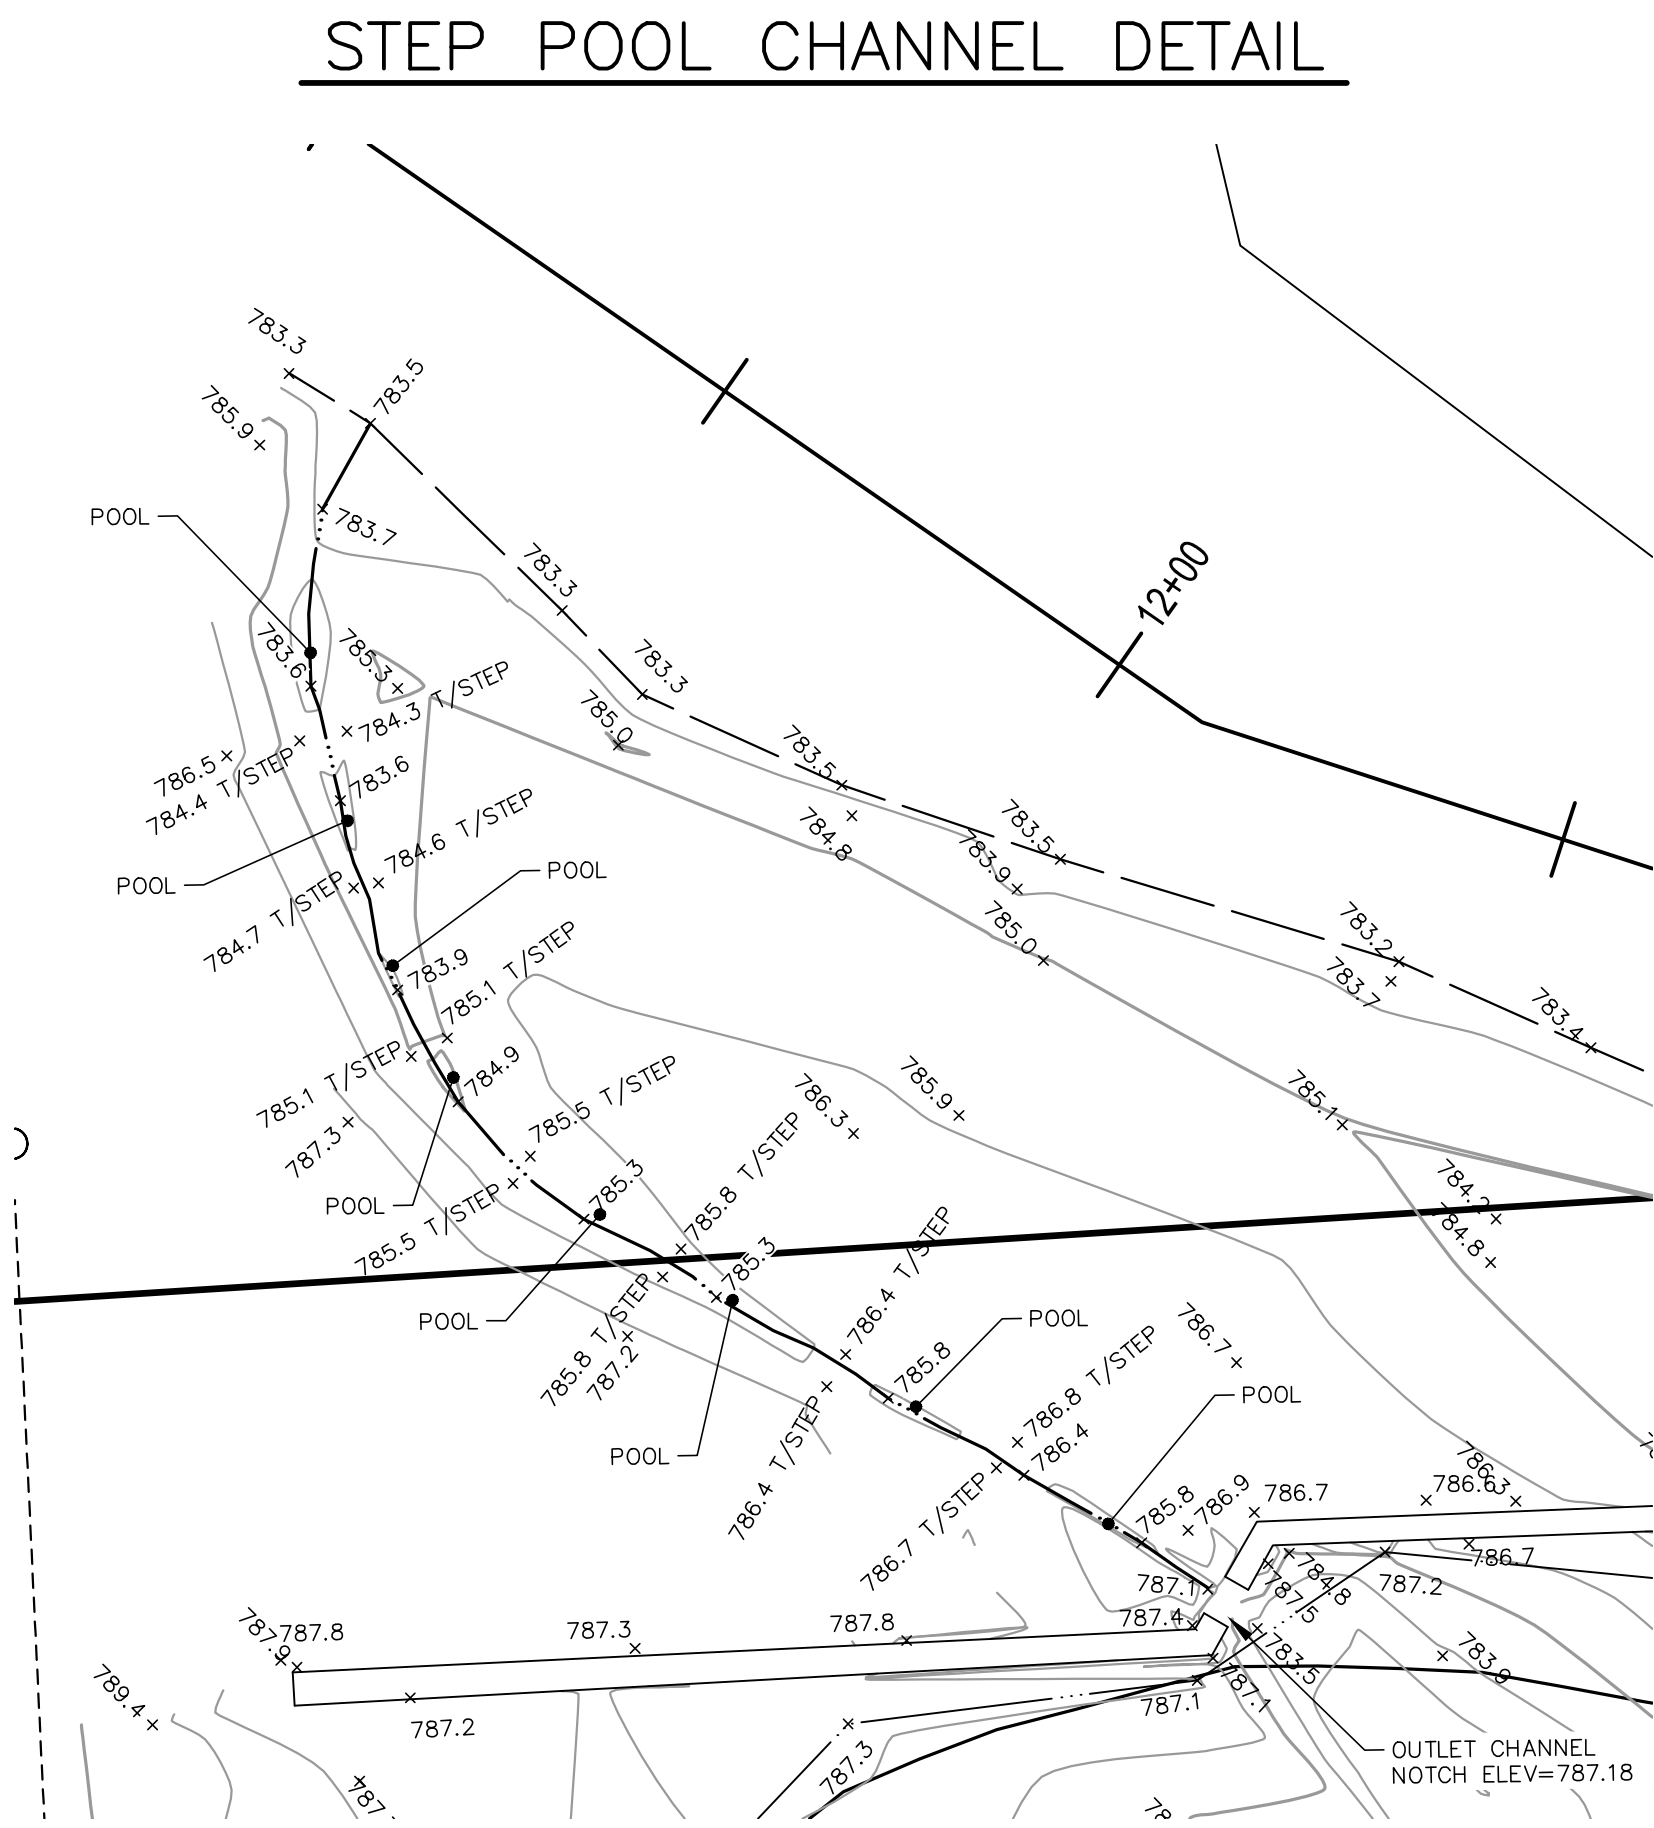

JOHNSON CREEK
FISH HATCHERY
FINAL AS-BUILTS

2

MIDWESTERN
CONSULTING
385 Plaza Drive Ann Arbor, Michigan 48108
734.995.0200 • www.midwesternconsulting.com
Land Development • Surveying • Engineering • Construction Management • Wireless Communications • Transportation • Landfill Services

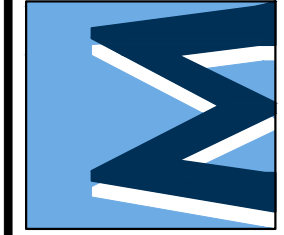

CLIENT
Anglin Civil
13000 Newburg Rd
Livonia, MI 48150

JOB No.	20209	DATE: 11/02/2020
REVISIONS:	SHEET 2 OF 2	
Added Point Bar Area/Rock/Vanes	12/31/20	CADD: rgt
Added access drive	2/3/21	ENG: rgt
		TECH: rgt
		20209_SV01
		FB#