



**WAYNE ROAD
DAM REMOVAL
PROJECT**
WAYNE COUNTY, MICHIGAN
CONTROL NO. 37-12-084

IN PARTNERSHIP WITH:
 OURS TO PROTECT
Working together, restoring the river




ISSUED FOR BIDS 3-27-12
FOR CONSTRUCTION DEC. 2011
FOR PERMITTING 8-9-11

101086
ECT PROJECT NUMBER
LH/MBI/AB DESIGNED BY
AB/AM/TH/PH DRAWN BY
LH CHECKED BY
JOM APPROVED BY

SHEET TITLE
**WAYNE ROAD
AS-BUILTS**
(FOR INFORMATION
ONLY)

NOT TO SCALE

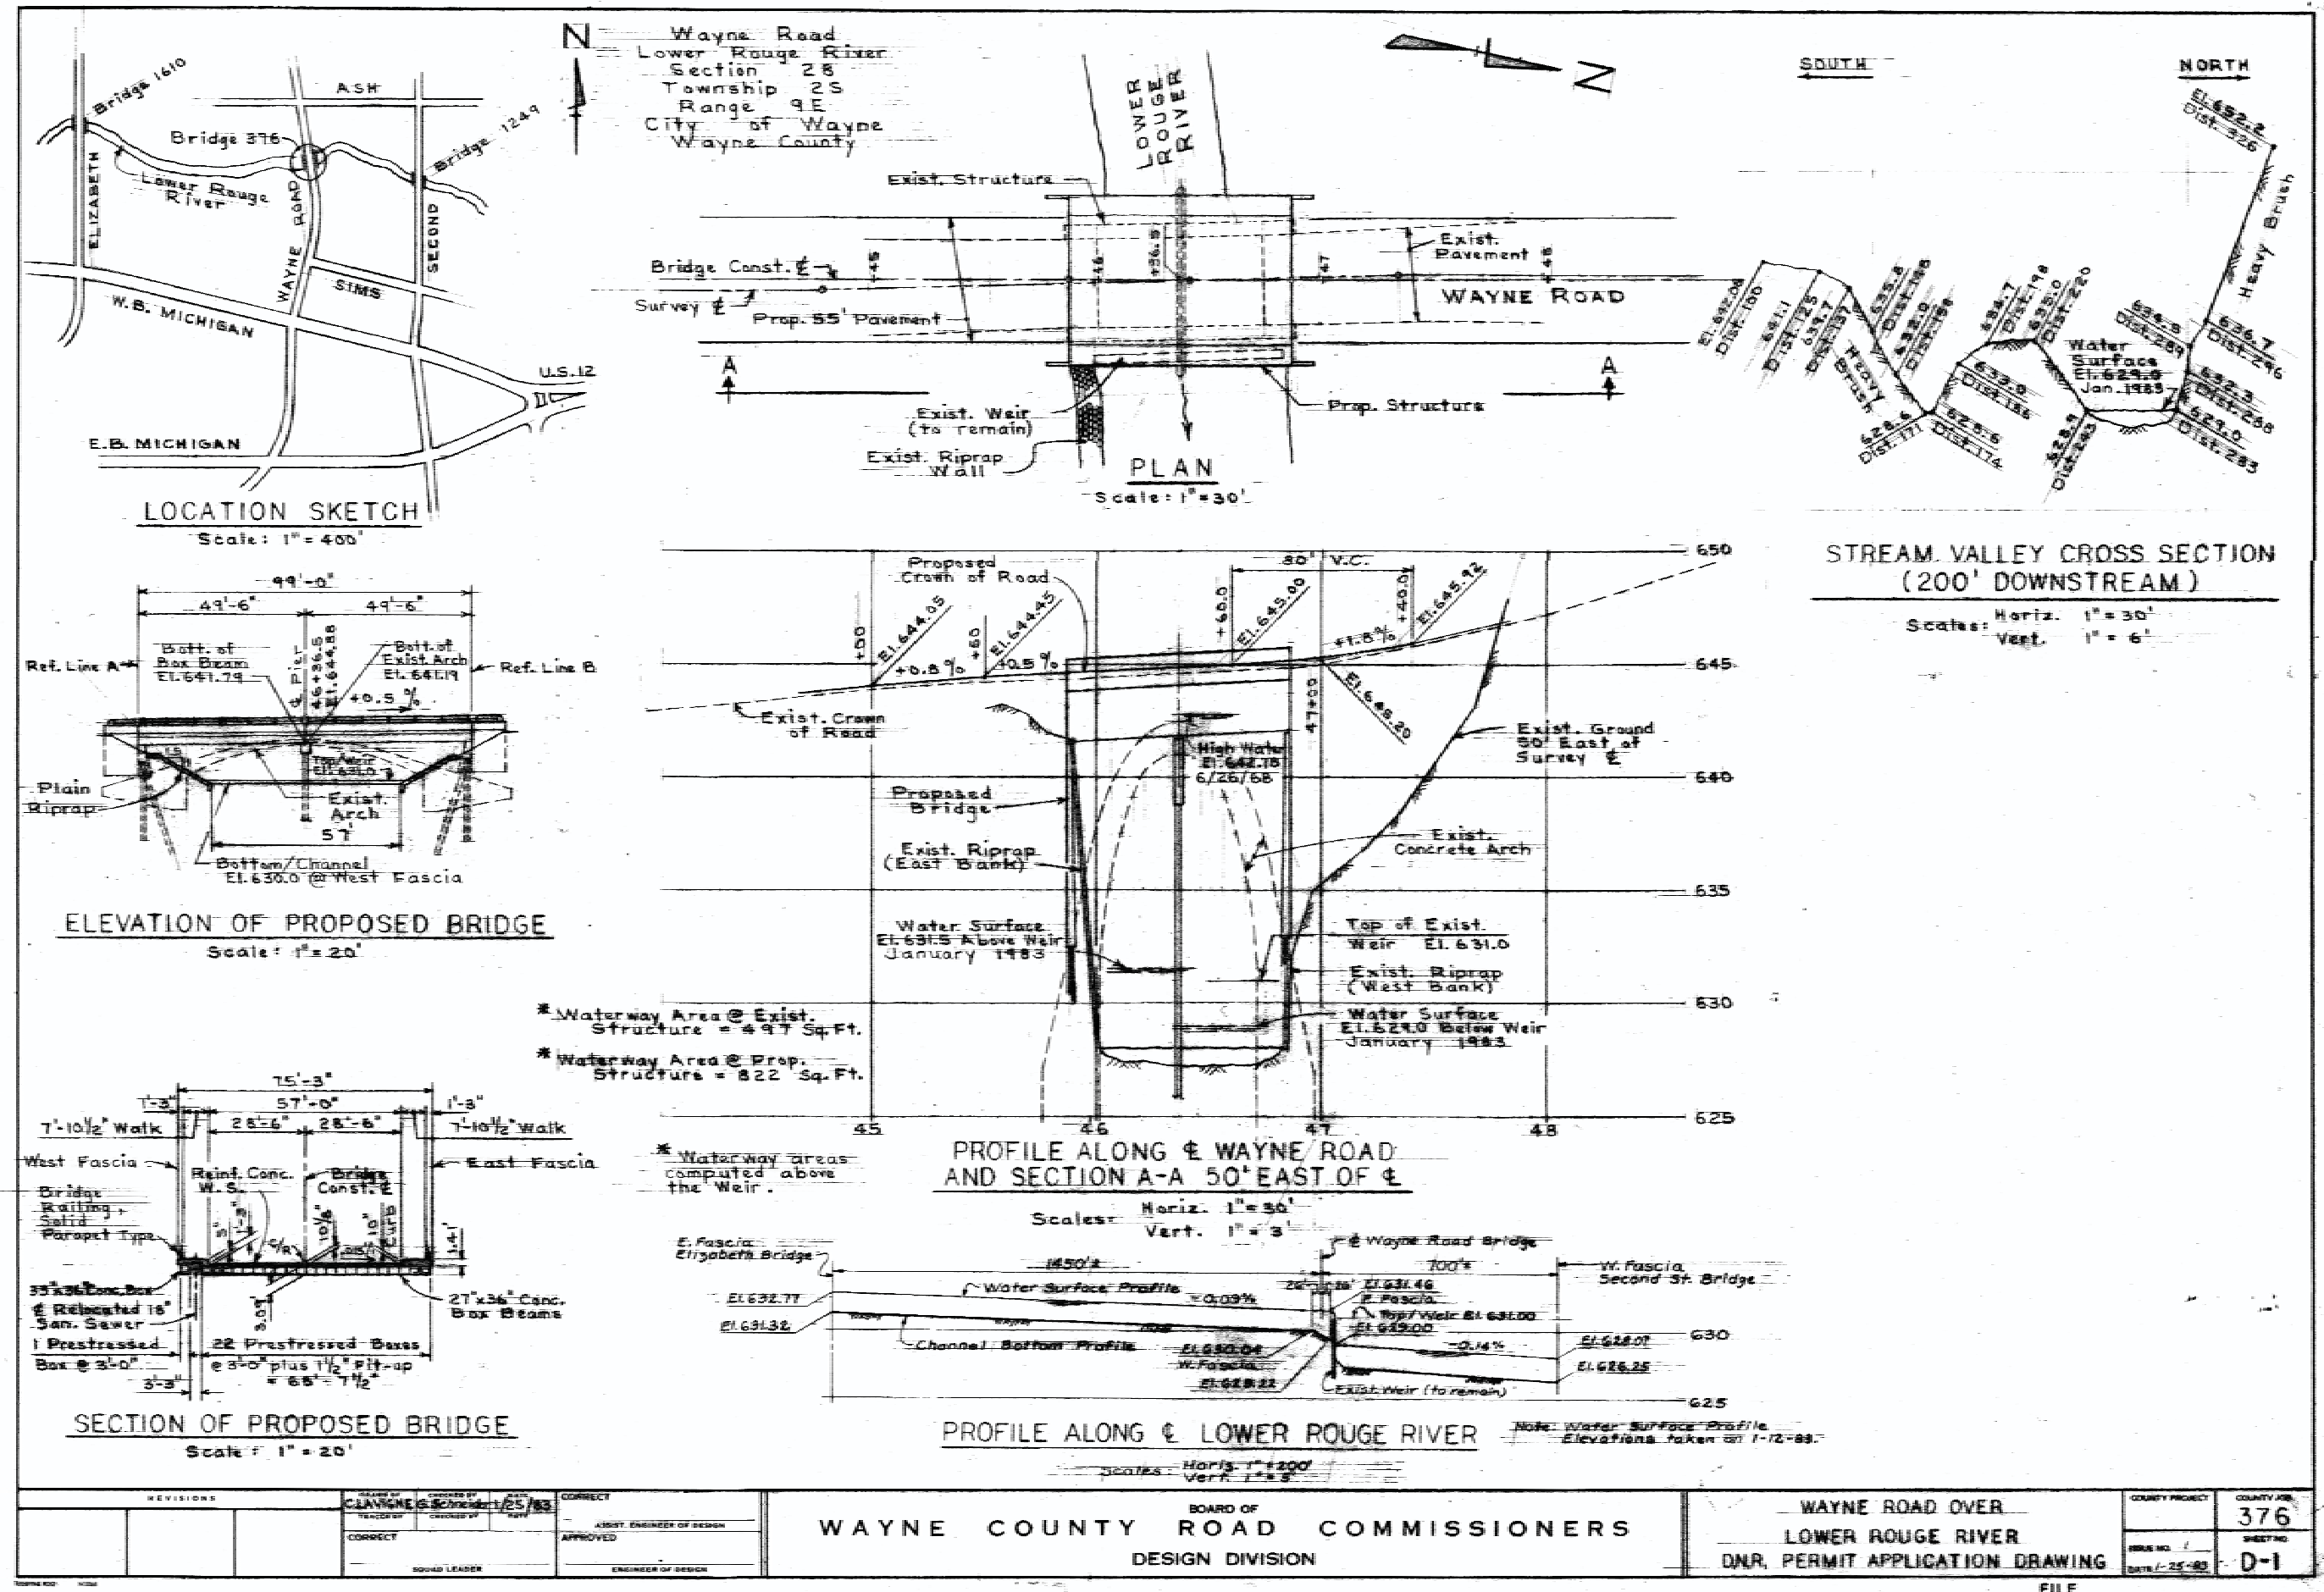



WAYNE ROAD DAM REMOVAL PROJECT
WAYNE COUNTY, MICHIGAN
CONTROL NO. 37-12-084

IN PARTNERSHIP WITH:







ISSUED FOR BIDS 5-27-12
FOR CONSTRUCTION DEC. 2011
FOR PERMITTING 8-9-11

101066
ECT PROJECT NUMBER
LH/MBI/AB DESIGNED BY
AB/AM/TH/PH CHECKED BY
DRAWN BY JOM APPROVED BY

SHEET TITLE
WAYNE ROAD AS-BUILTS
(FOR INFORMATION ONLY)

NOT TO SCALE
SHEET NUMBER
A-2

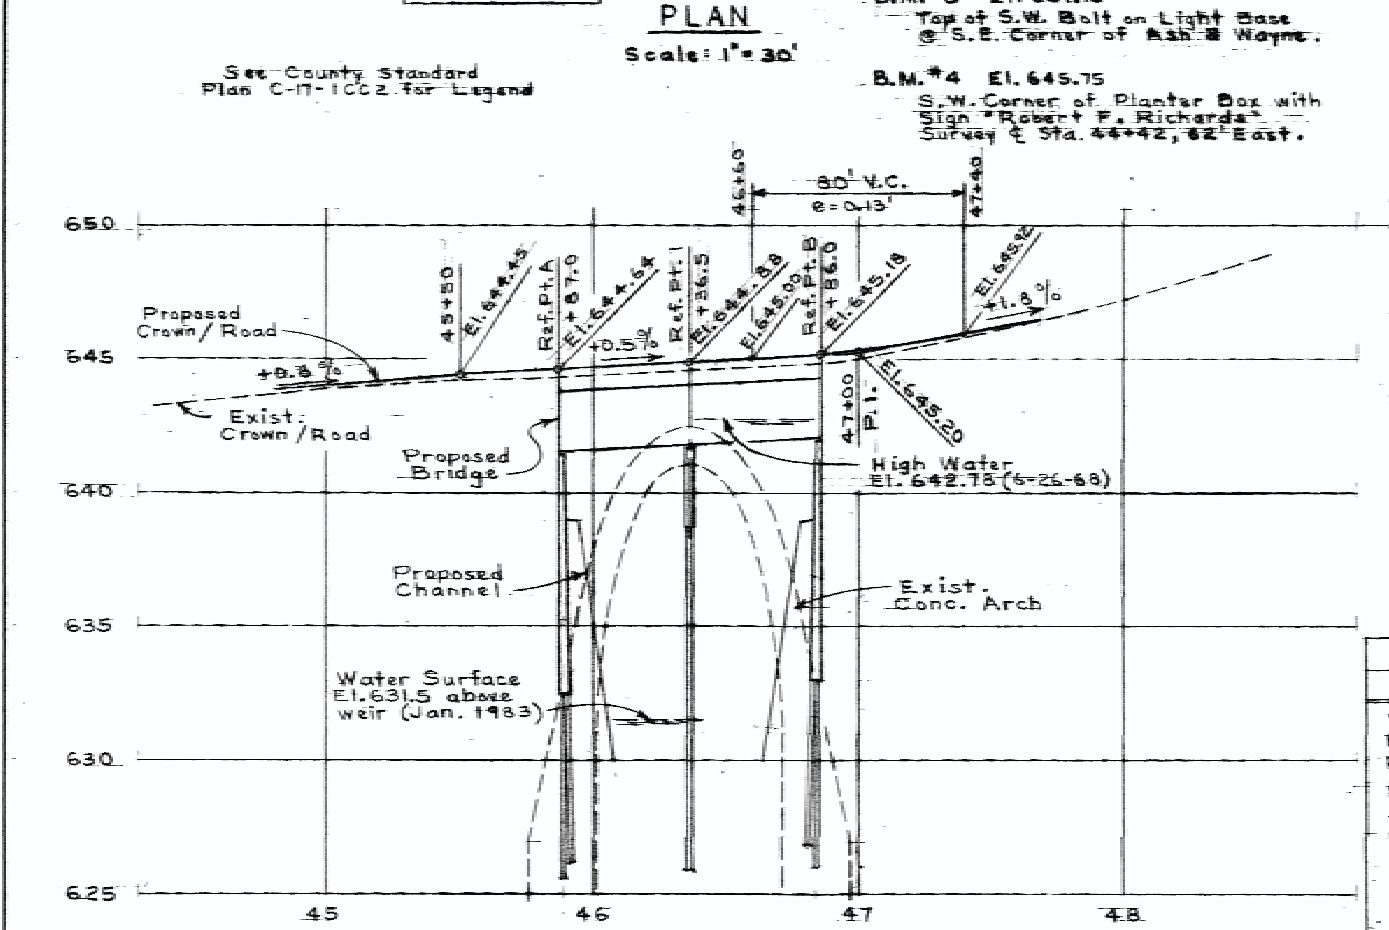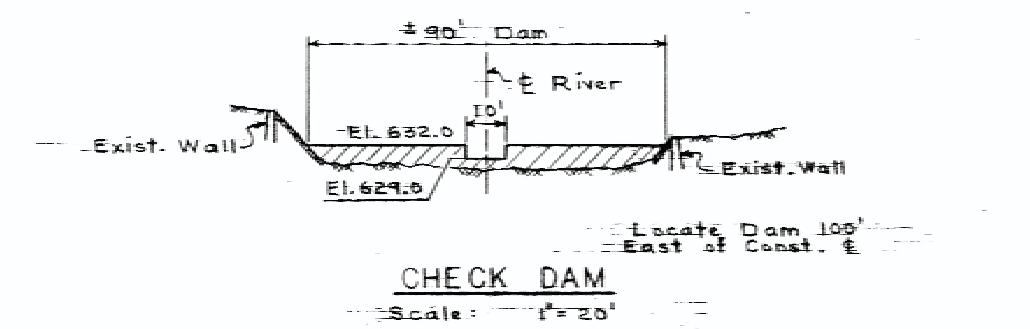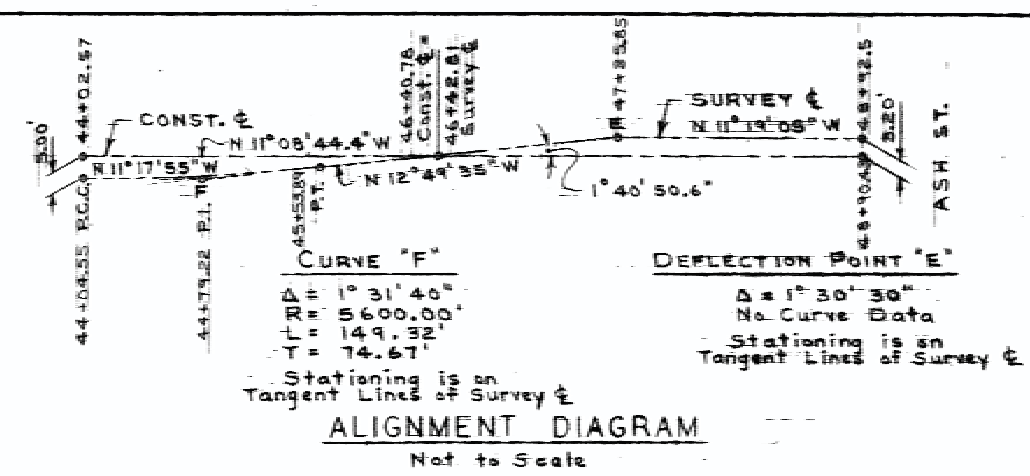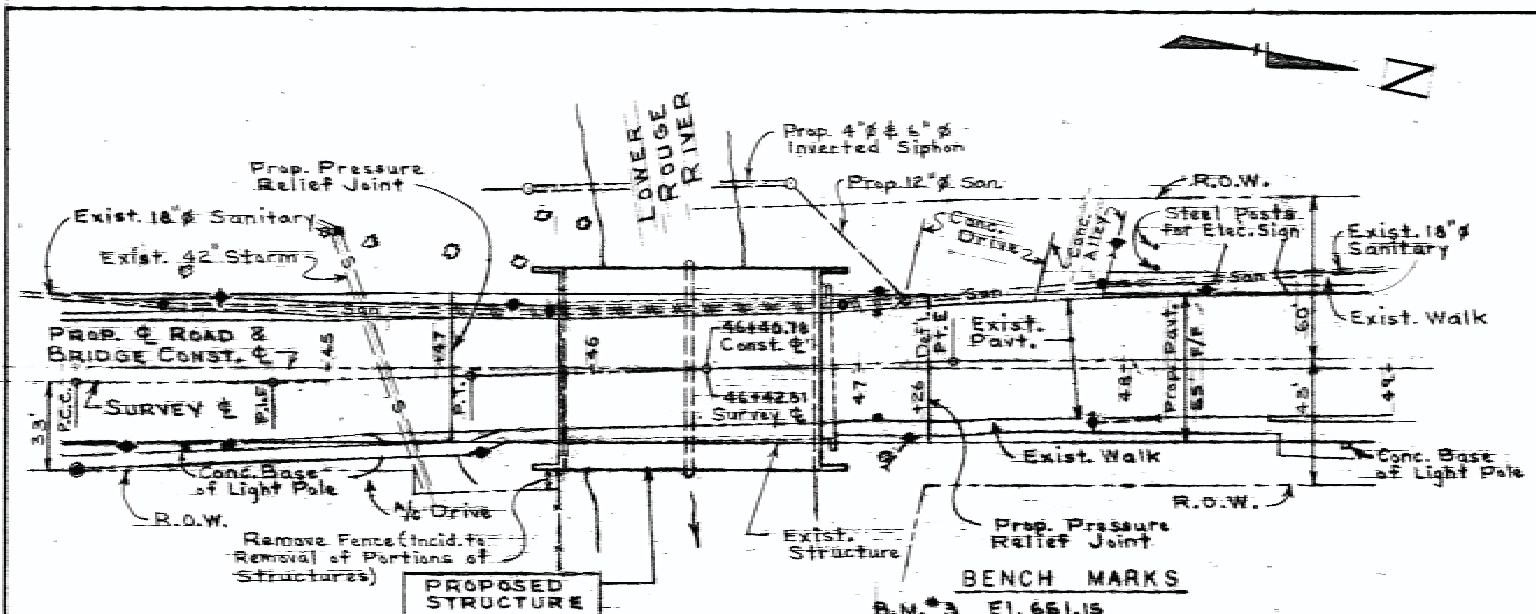

QUANTITIES		
Item	Unit	Amount
Check Dams	Lin. Ft.	90
Hay or Straw Bales	Each	50
Project Clean-up	L.S.	1
On the Job Training	Each	2

GENERAL NOTES

The work covered by these plans includes removal of portions of the existing structure, construction of the proposed bridge and placing backfill and slope protection. Other work in this contract is included in road and sanitary sewer plans.

The Contractor shall locate all active underground utilities prior to starting work, and shall conduct his operations in such a manner as to insure that these utilities not requiring relocation will not be disturbed.

The Contractor shall contact utility companies regarding their facilities prior to starting work.

Wayne Road will be closed to traffic in the vicinity of construction until bridge and sewer work is completed.

Datum refers to U.S.C. & G.S. Datum.

It shall be the responsibility of the Contractor to maintain the uninterrupted flow of the river.

Water level is subject to change. The Contractor is responsible for making his own determination of water levels that will exist during construction.

REFERENCE
Topo. Field Book T 45-21
Levels. Field Book L 45-17

WAYNE COUNTY
"AS CONSTRUCTED"
By: R.E.M. Checked by: G.S. Date: JAN 22 2005

REVISIONS	DESIGNED BY	CHECKED BY	DATE
2 Misc. 4-14-83	CLAYTON G.R.S.	1/14/83	
	APPROVED		
	APPROVED		

BOARD OF
WAYNE COUNTY ROAD COMMISSIONERS
DESIGN DIVISION

WAYNE ROAD OVER LOWER ROUGE RIVER LOCATION PLAN
COUNTY PROJECT 376
SHEET NO. 102
DATE 4-14-83

81 OF 82-3-25



**WAYNE ROAD
DAM REMOVAL
PROJECT**
WAYNE COUNTY, MICHIGAN
CONTROL NO. 37-12-084

IN PARTNERSHIP WITH:



ISSUED FOR BIDS 9-27-12
FOR CONSTRUCTION DEC. 2011
FOR PERMITTING 8-9-11

101086
ECT PROJECT NUMBER
LH/MBI/AB DESIGNED BY
LH CHECKED BY
AB/AM/TH/PH DRAWN BY
JOM APPROVED BY

SHEET TITLE

**WAYNE ROAD
AS-BUILTS**


(FOR INFORMATION
ONLY)

NOT TO SCALE




SHEET NUMBER

A-3

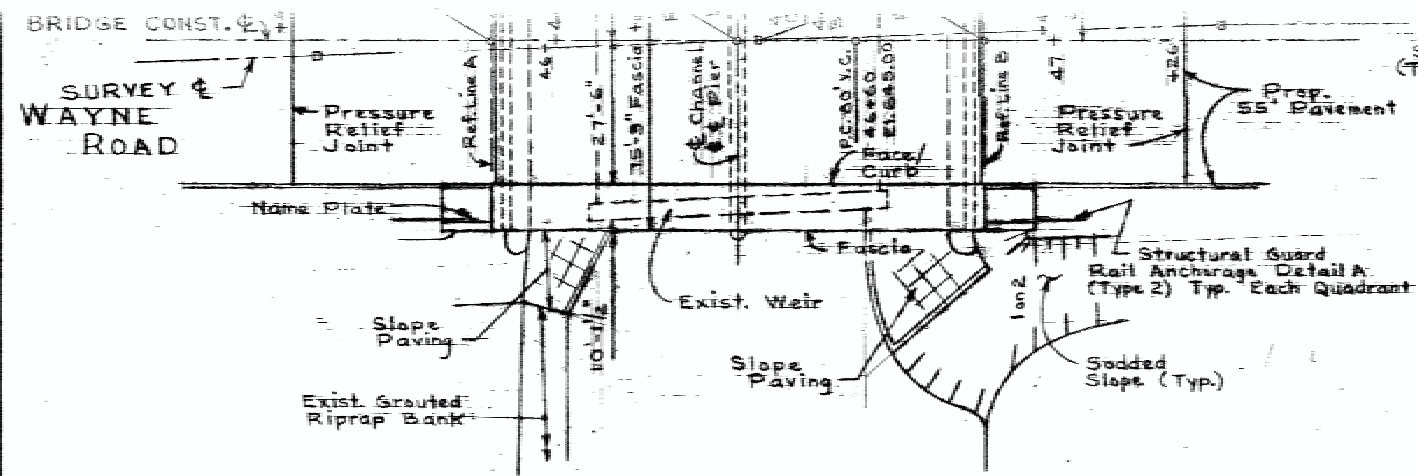

PLAN

Scale: 1/16" = 1'-0"

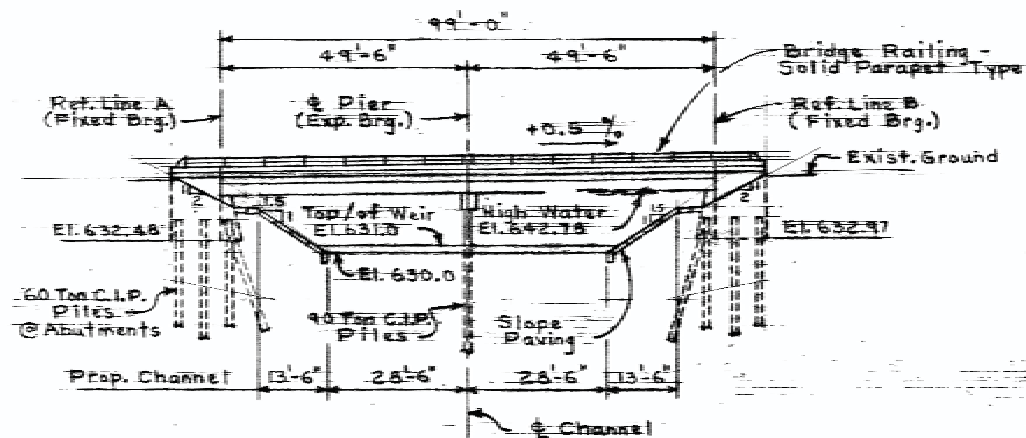

ELEVATION


Scale: 1/16" = 1'-0"

* Not a Pay Item

** Included with Road Plans.
(Quantities @ corners at
bridge between bridge fascia
and abut. ref. lines)

QUANTITIES

Item	Unit	Amount
Cofferdams	L.S.	1
Unclassified Foundation Excavation	Cu. Yds.	181
Structure Backfill C.I.P.	Cu. Yds.	500
Slope Paving, Concrete	Sq. Yds.	420
Mobilization	L.S.	1
Slope Protection Headers	Lin. Ft.	280
* Selected Excavated Material	Cu. Yds.	300
* Porous Backfill, Grade A (C.I.P.)	Cu. Yds.	315
* Embankment C.I.P.	Cu. Yds.	133
* Class B Sodding	Sq. Yds.	100

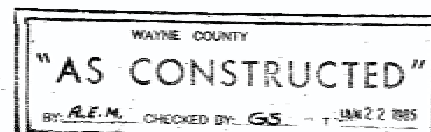

Work this Sheet with Sheet No. 105

BOARD OF
WAYNE COUNTY ROAD COMMISSIONERS
DESIGN DIVISION

**WAYNE ROAD OVER
LOWER ROUGE RIVER
GENERAL PLAN OF STRUCTURE I**

COUNTY PROJECT
376
SHEET NO.
104

REVISIONS	DESIGNED BY	CHECKED BY	DATE	CORRECT
20 MISC 4-14-85	CLANIGRE	R.J.P.	1/24/85	L.P. CLANIGRE
	CORRECT	George Schneider		APPROVED C. Schneider, W.S. ENGINEER OF DESIGN

BI OF 82-13-25



**WAYNE ROAD
DAM REMOVAL
PROJECT**
WAYNE COUNTY, MICHIGAN
CONTROL NO. 37-12-084

IN PARTNERSHIP WITH:


OURS TO PROTECT
Working together, restoring the river



ISSUED FOR BIDS	3-27-12
FOR CONSTRUCTION	DEC. 2011
FOR PERMITTING	8-9-11
101086 ECT PROJECT NUMBER	
LH/MBI/AB DESIGNED BY	LH CHECKED BY
AB/AM/TH/PH DRAWN BY	JOM APPROVED BY

SHEET TITLE
**WAYNE ROAD
AS-BUILTS**
(FOR INFORMATION
ONLY)

NOT TO SCALE

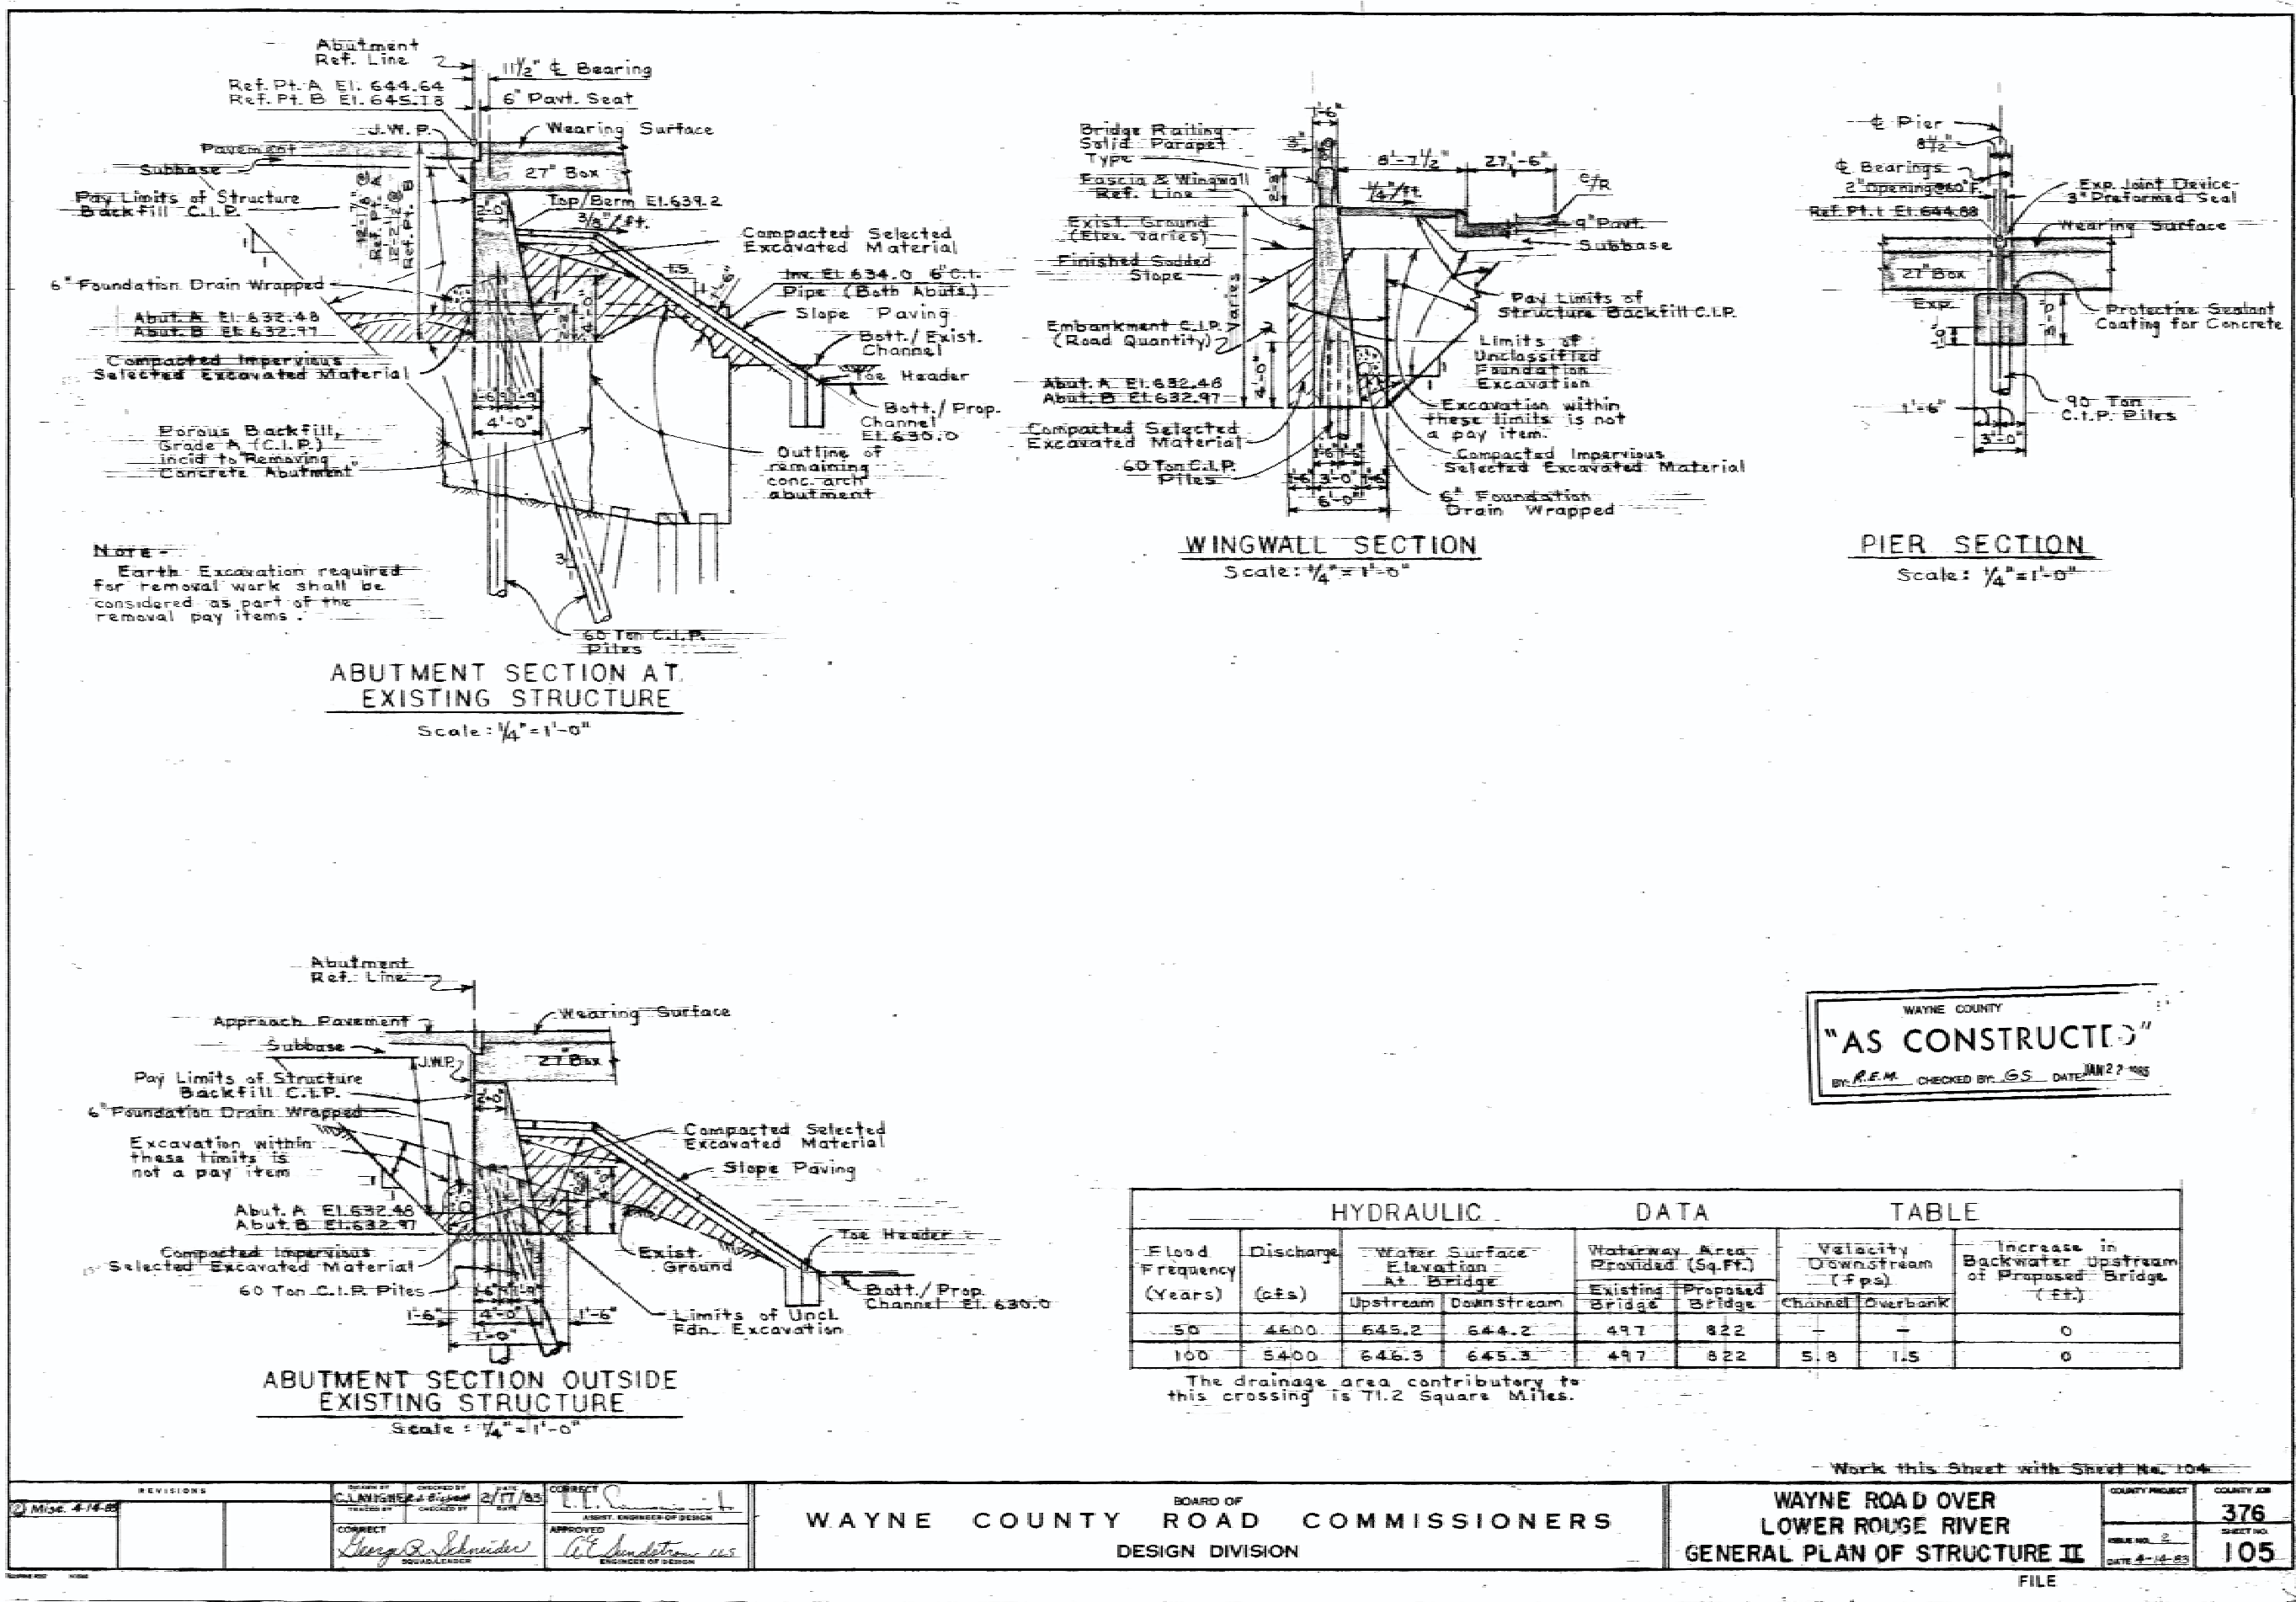

REVISIONS 1) Misc. 4-14-85		DRAWN BY C. LANGRISH	CHECKED BY R. SCHWIDER	DATE 2/17/85	CORRECT L. C.	APPROVED R. C.	BOARD OF WAYNE COUNTY ROAD COMMISSIONERS DESIGN DIVISION	WAYNE ROAD OVER LOWER ROUGE RIVER GENERAL PLAN OF STRUCTURE II	COUNTY PROJECT FILE NO. 2	COUNTY JOB 376	SHEET NO. 105
--------------------------------------	--	-------------------------	---------------------------	-----------------	------------------	-------------------	---	---	------------------------------	--------------------------	-------------------------

BI OF 82-1325